



Job Description: 8th & Hardesty Grid Repl Phase 5D




Maximo Work Order: 17061153
Project #: 802183

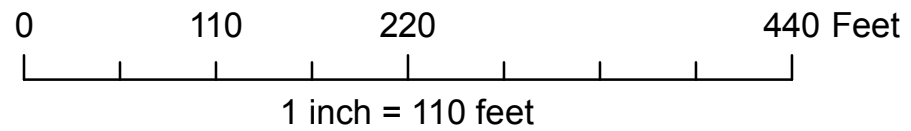

PAGE 2 OF 4

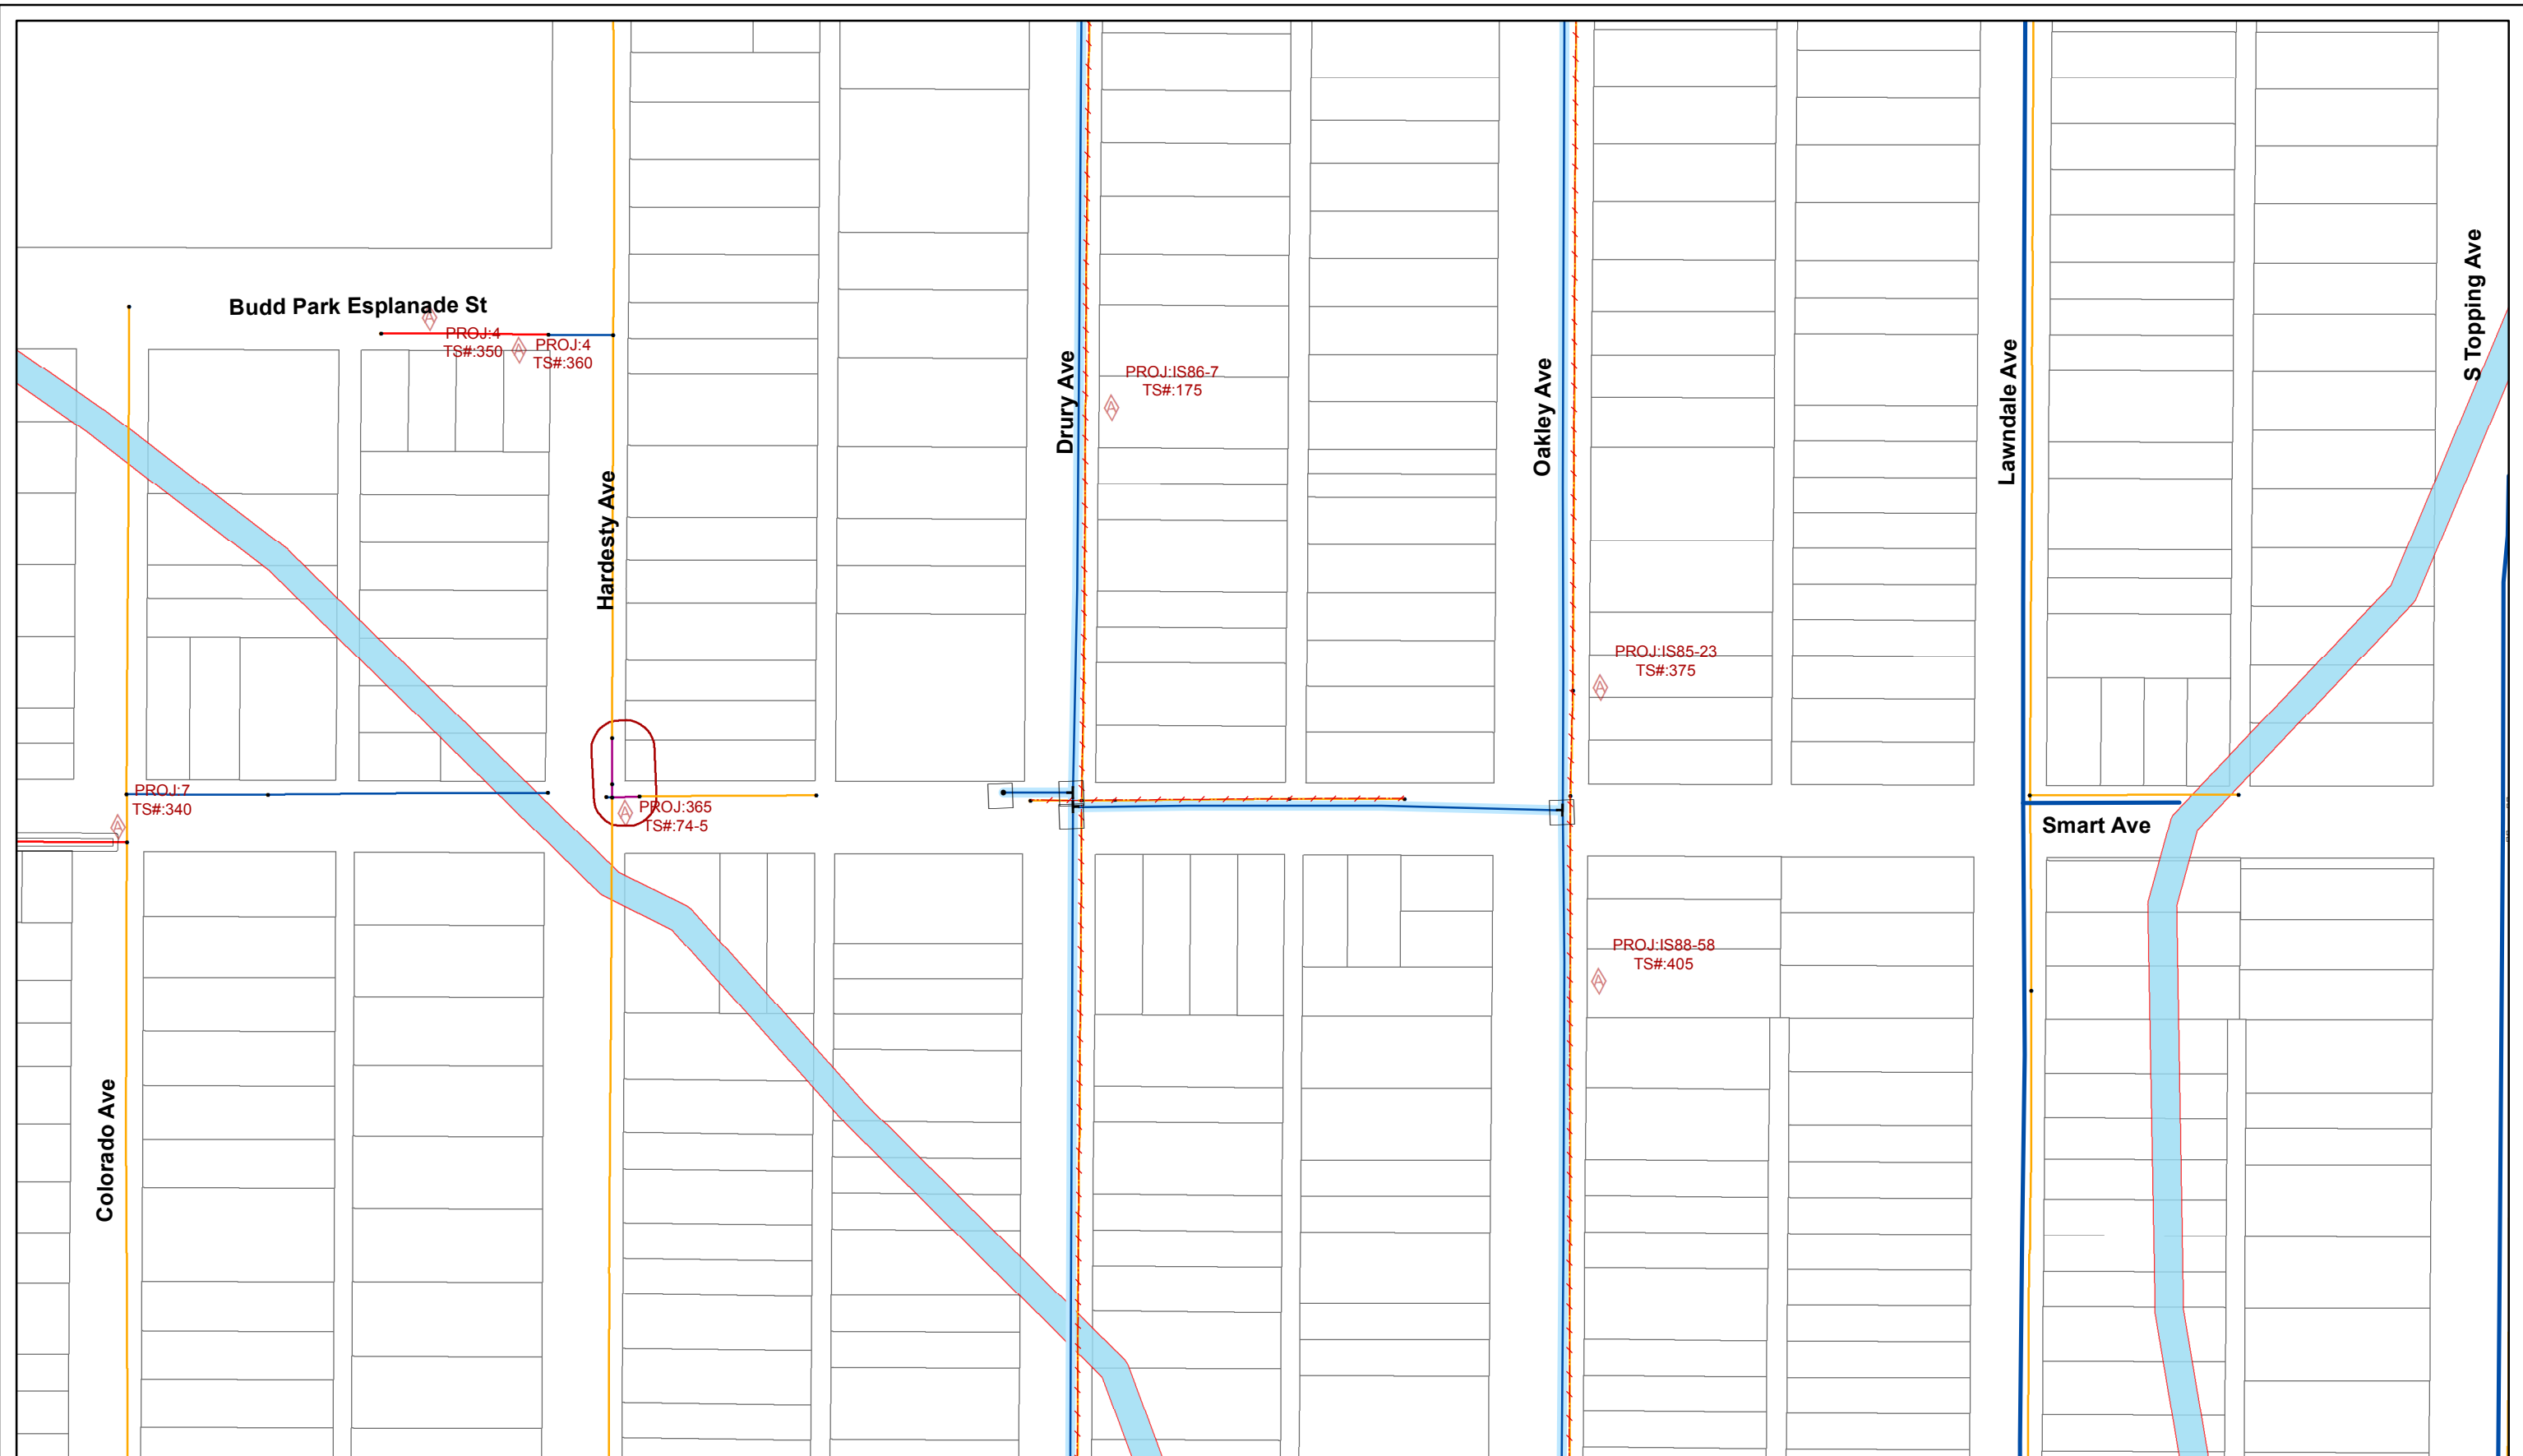


Job Description: 8th & Hardesty Grid Repl Phase 5D

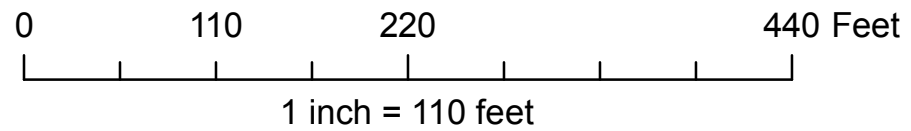


Maximo Work Order: 17061153
Project #: 802183



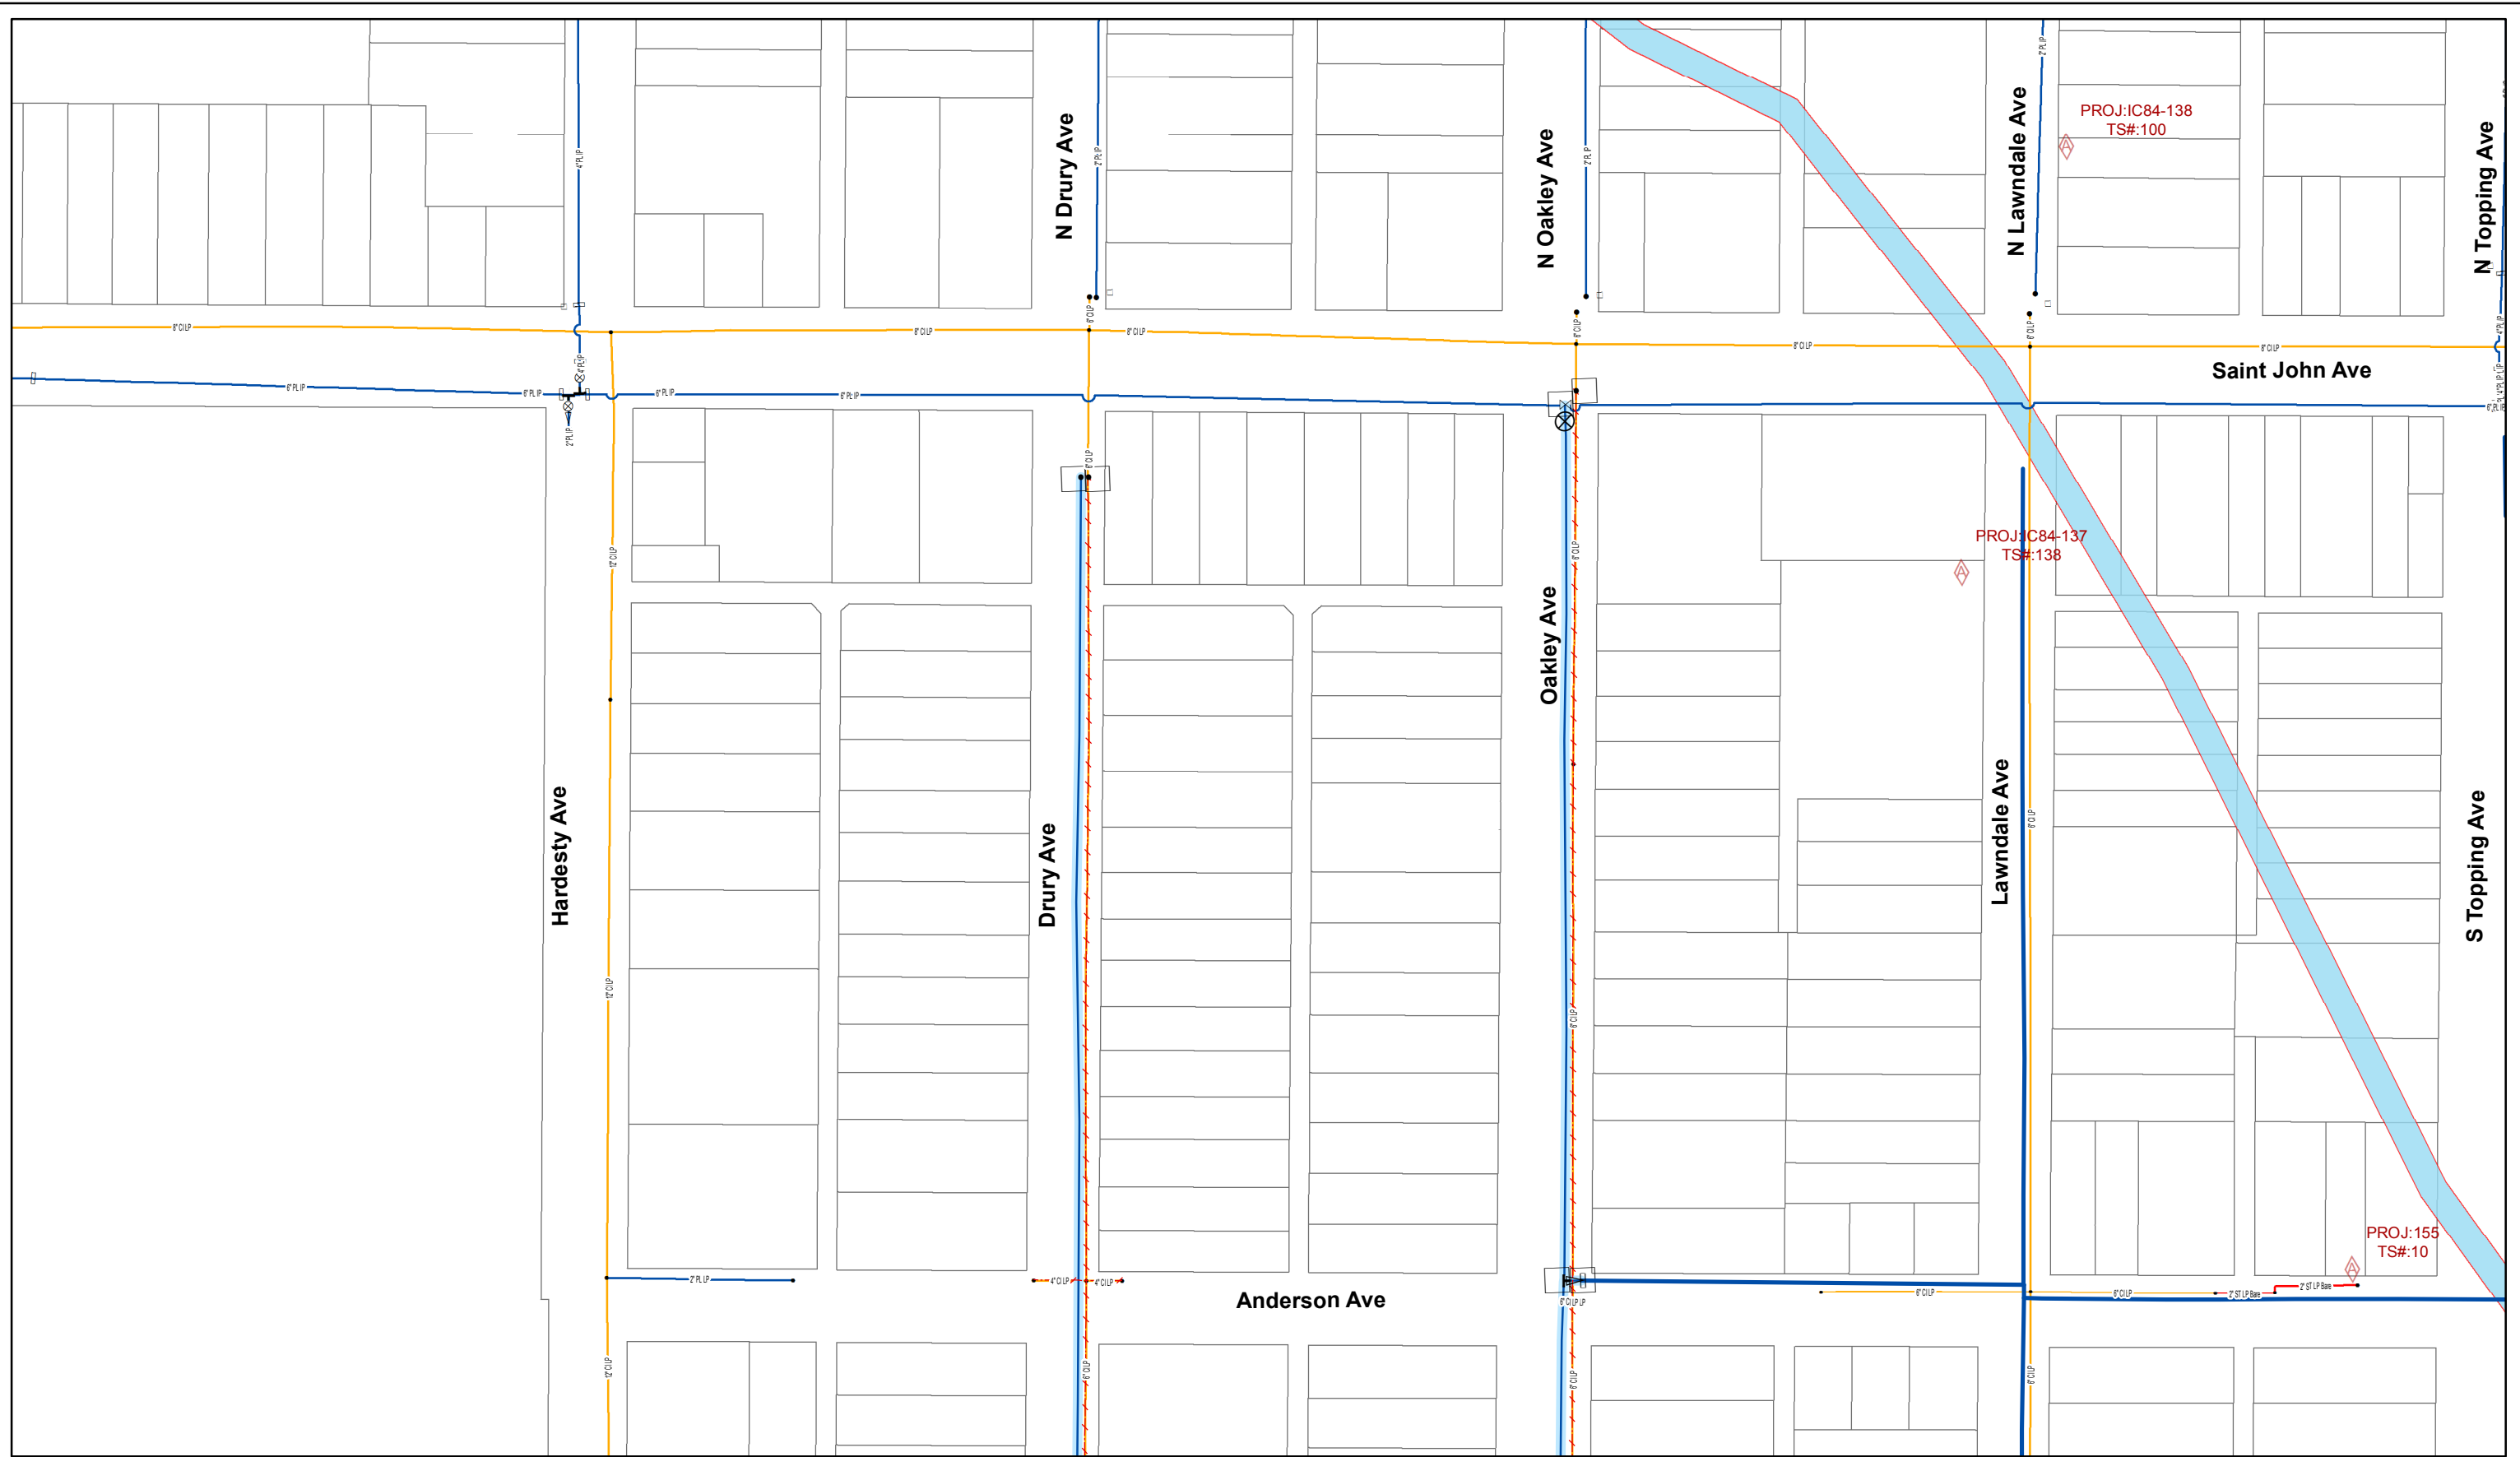

Job Description: 8th & Hardesty Grid Repl Phase 5D

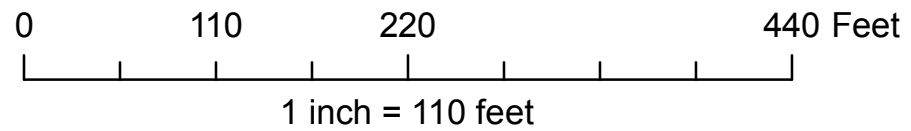

Maximo Work Order: 17061153
Project #: 802183

