



Job Description: 8th & Hardesty Grid Repl Phase 5C




Maximo Work Order: 17061150
Project #: 802184

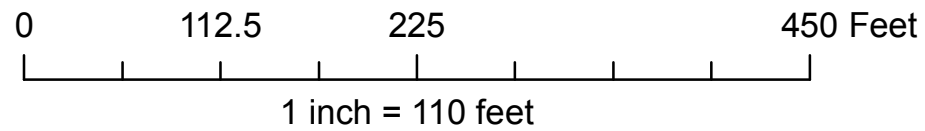

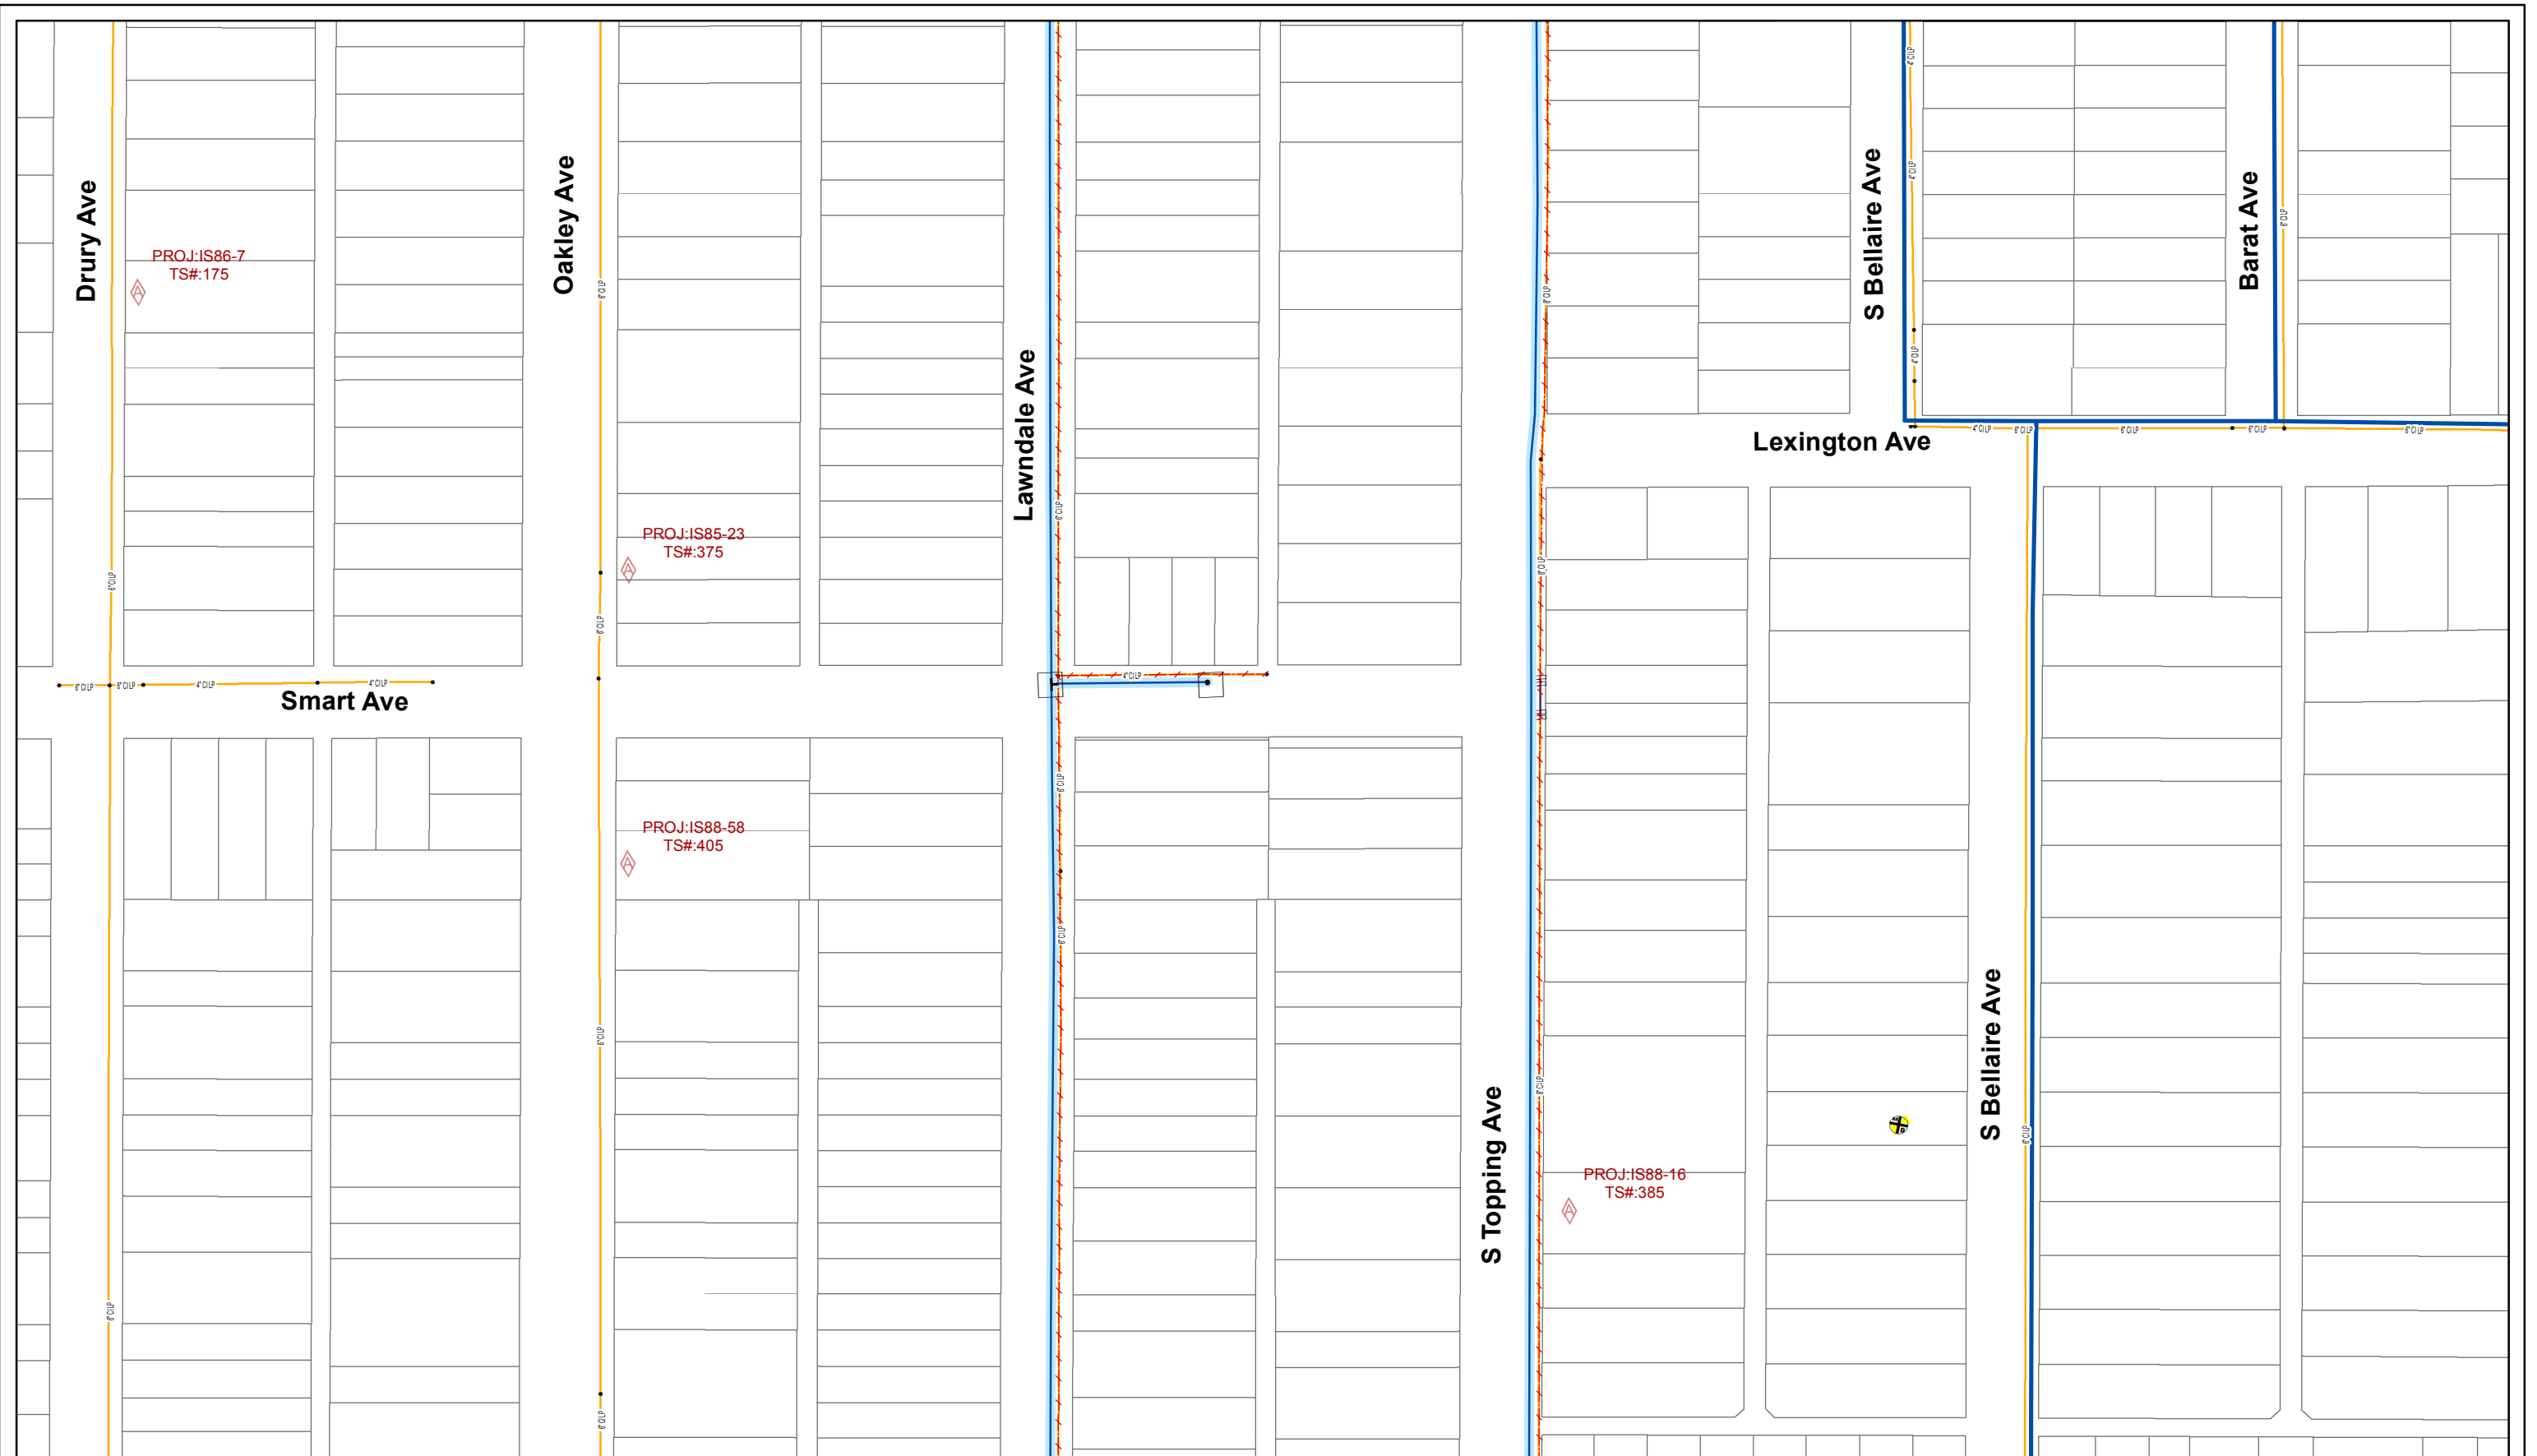


Job Description: 8th & Hardesty Grid Repl Phase 5C

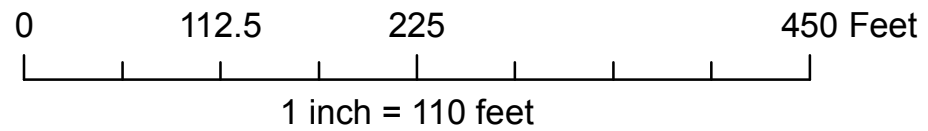


Maximo Work Order: 17061150
Project #: 802184



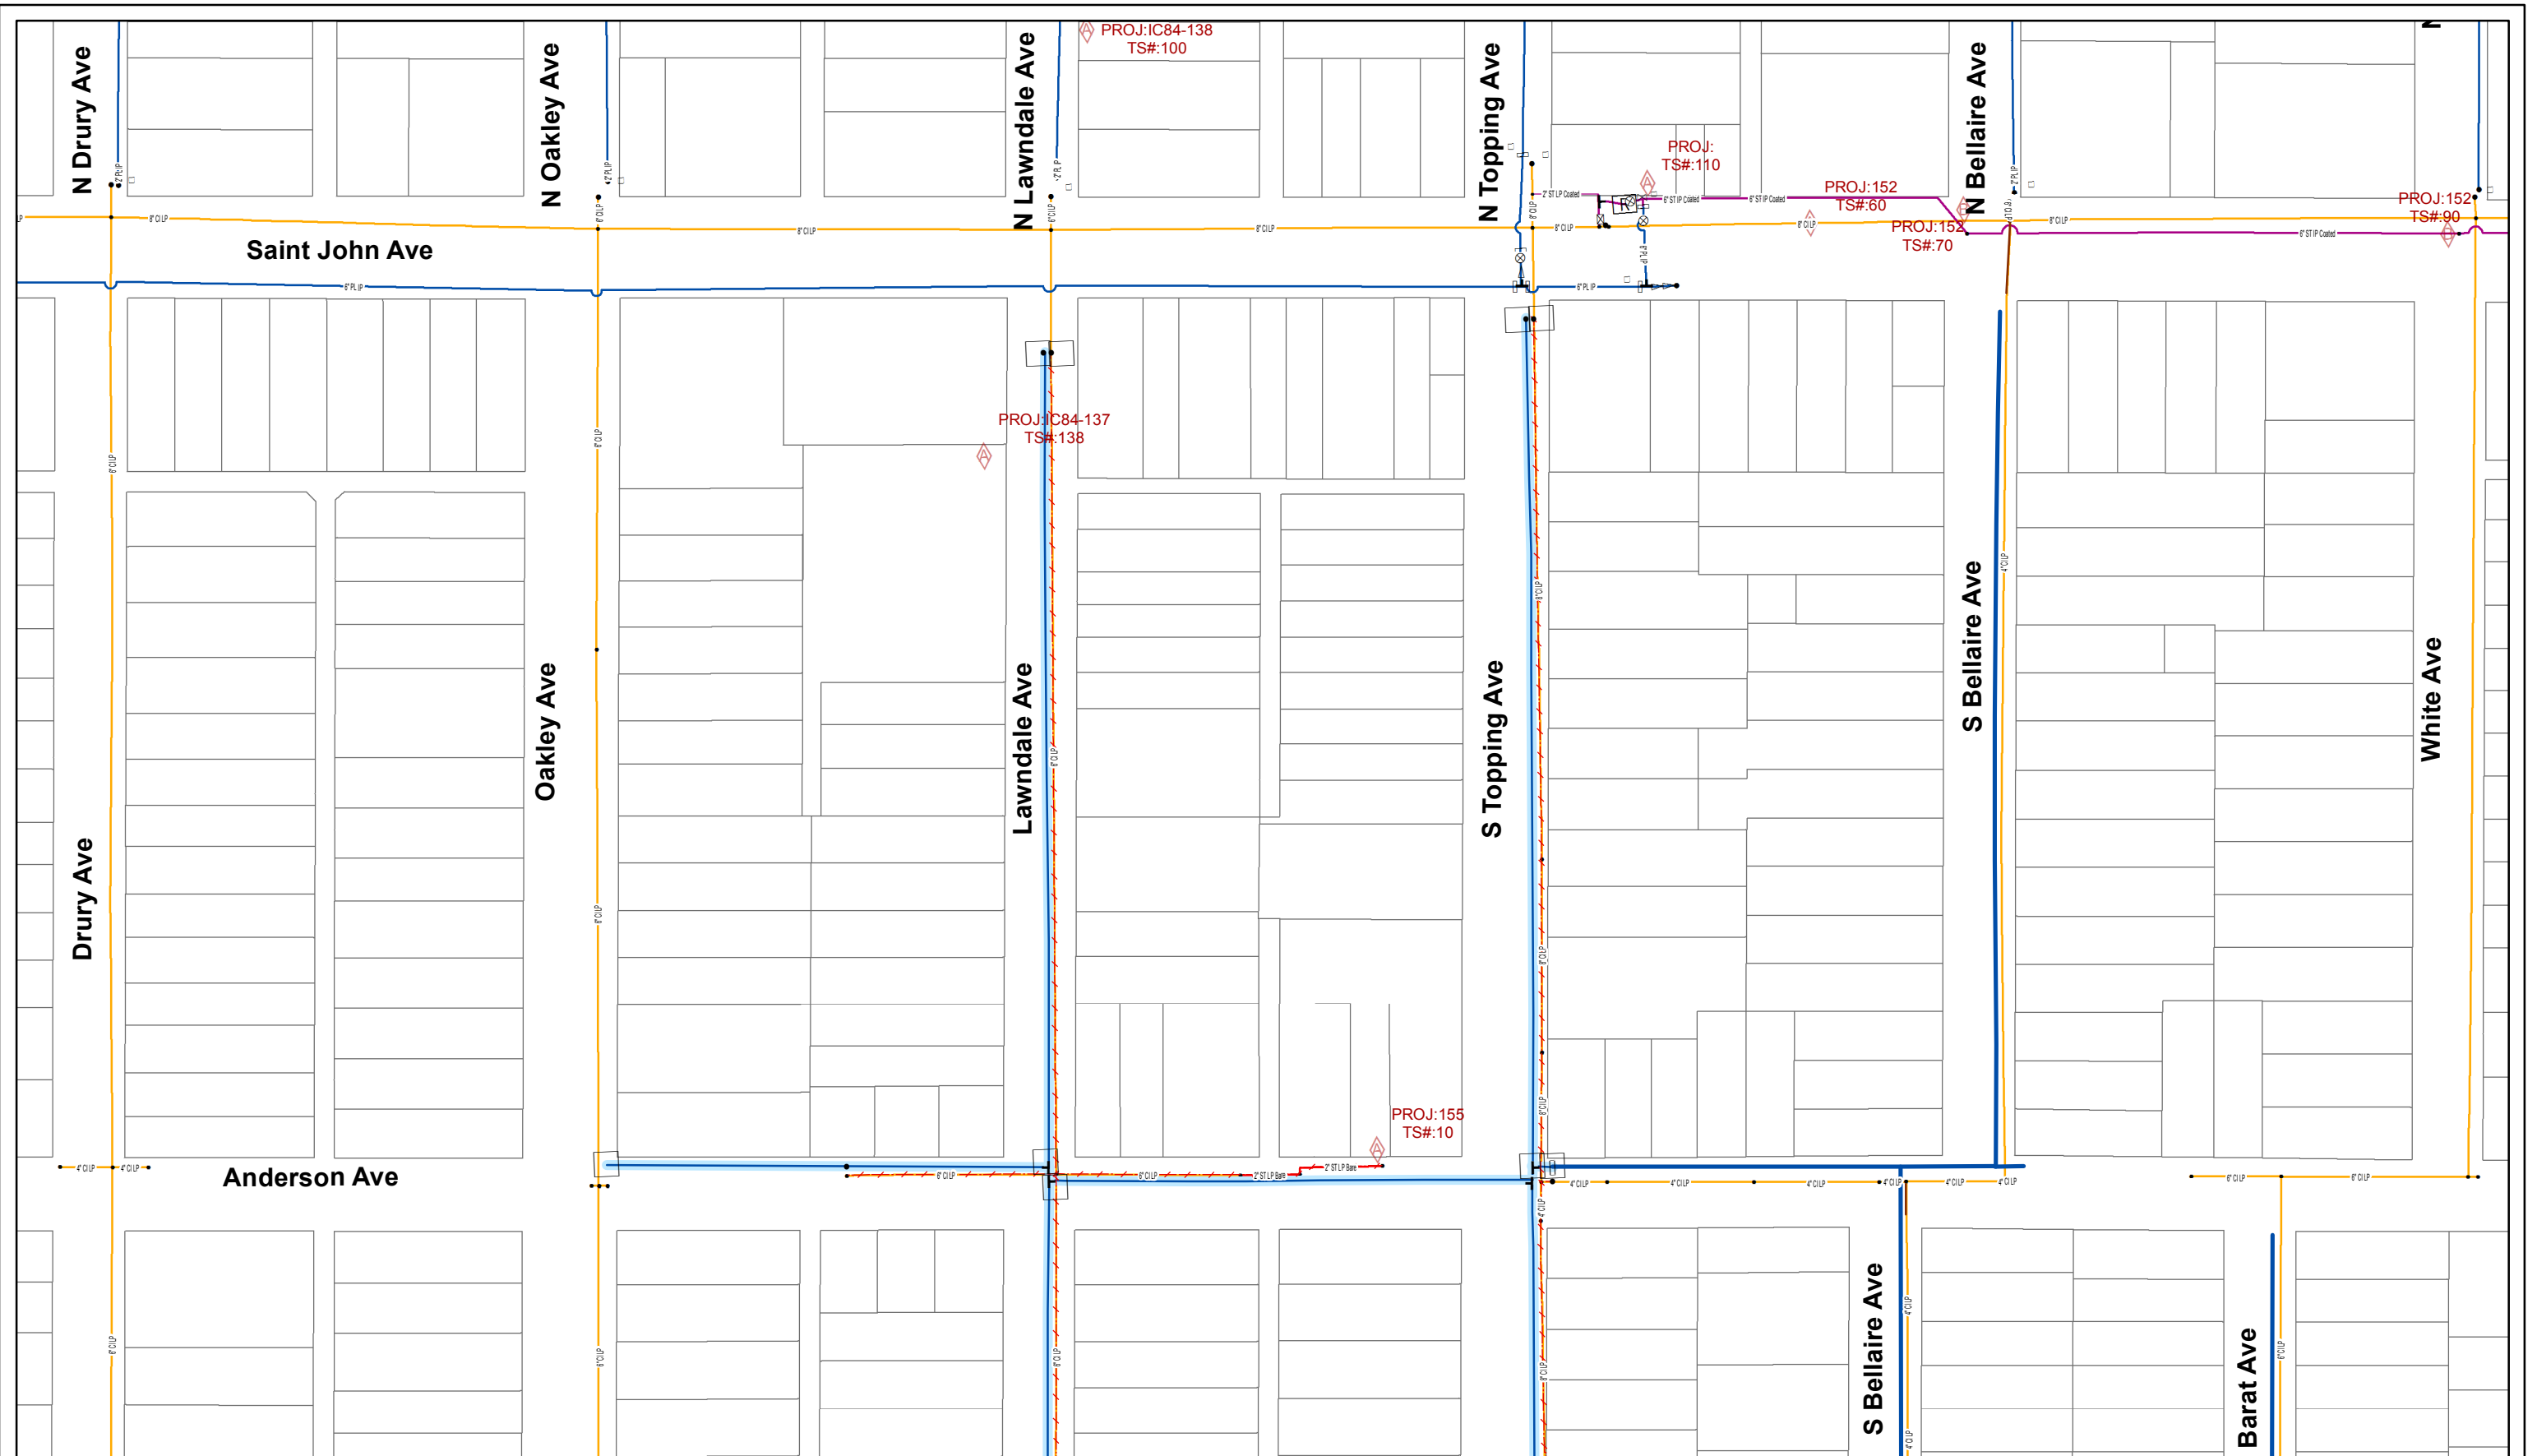

Job Description: 8th & Hardesty Grid Repl Phase 5C

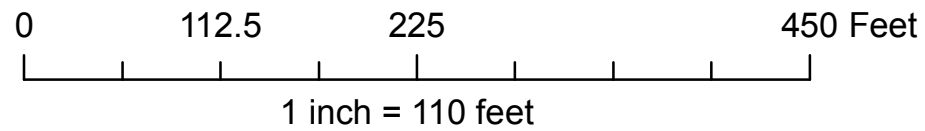

Maximo Work Order: 17061150
Project #: 802184

